111823

LET	DATE	E.C.N.	REVISION RECORD	BY
*	4/09	E-00258	Production Release	RA
A	6/09	T-02367	OBS ITEM 2 & 3	KP

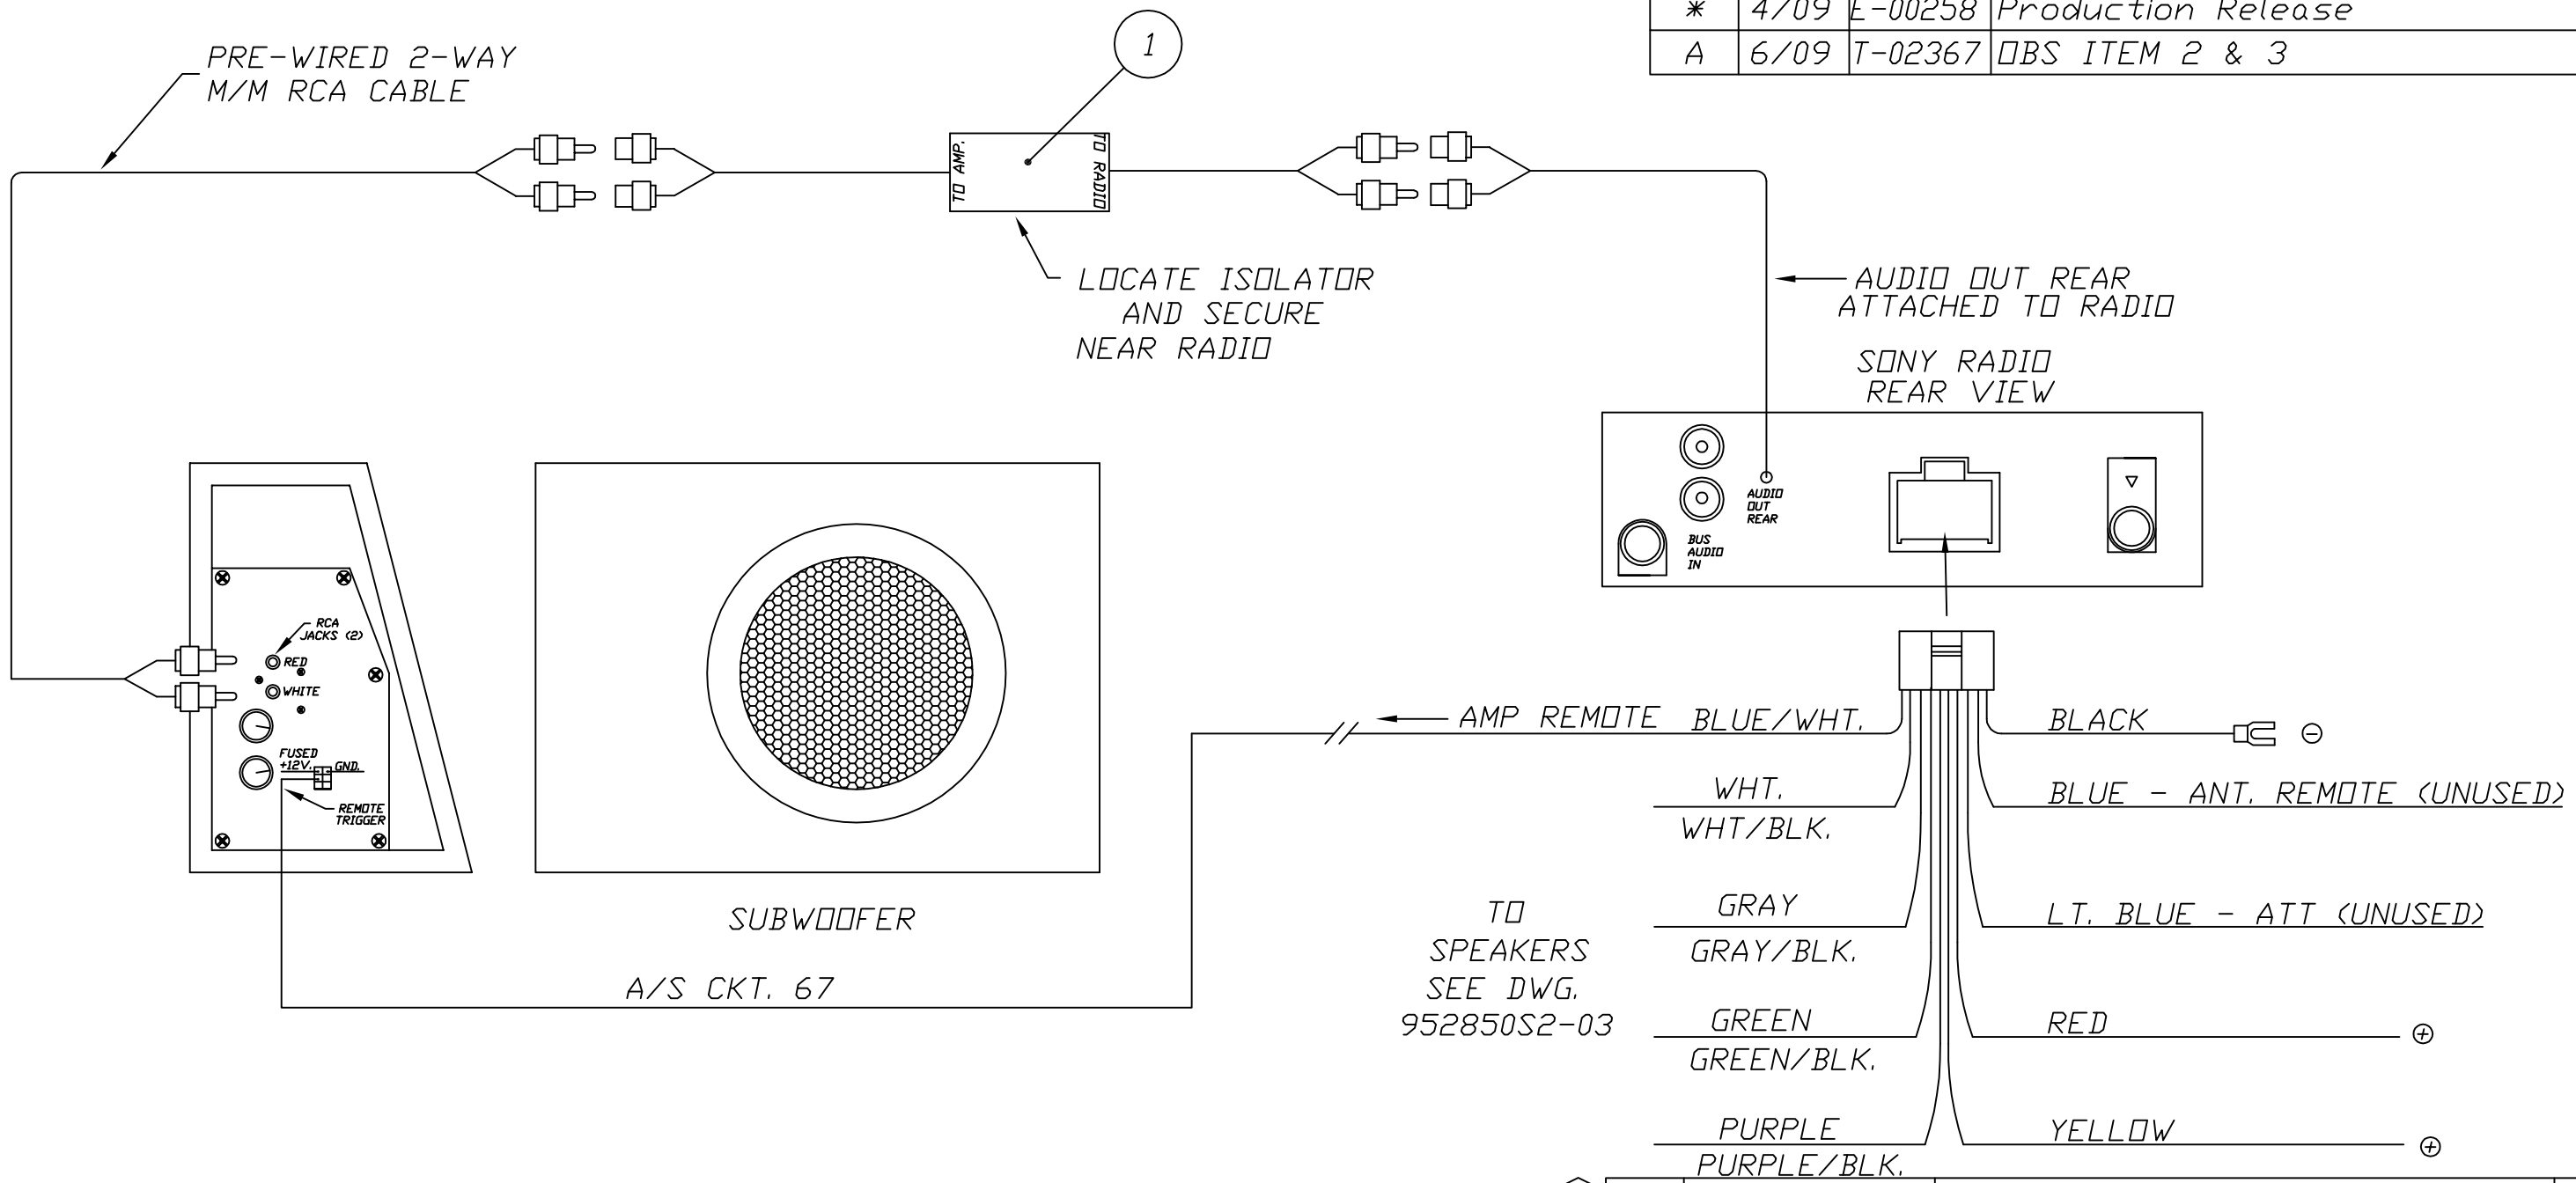

ITEM	PART NUMBER	DESCRIPTION	QTY	UM
(A) ~~3~~	~~512379~~	~~BARREL COUPLER RCA GOLD M/M~~	~~2~~	EA
(A) ~~2~~	~~512056~~	~~BARREL COUPLER RCA GOLD F/F~~	~~2~~	EA
1	511608	ISOLATION TRANSFORMER, 15 AMP	1	EA

TOLERANCES ± *

NEXT ASS'Y *

Airstream

FIRST USAGE: All Trlr's Except Sport

DRAWN BY RUSS A

APPROVED BY

TITLE Install, Ground Loop Islolator

SCALE	DATE	DRAWING NUMBER		REV.
NTS	4/28/09	111823	B	A